


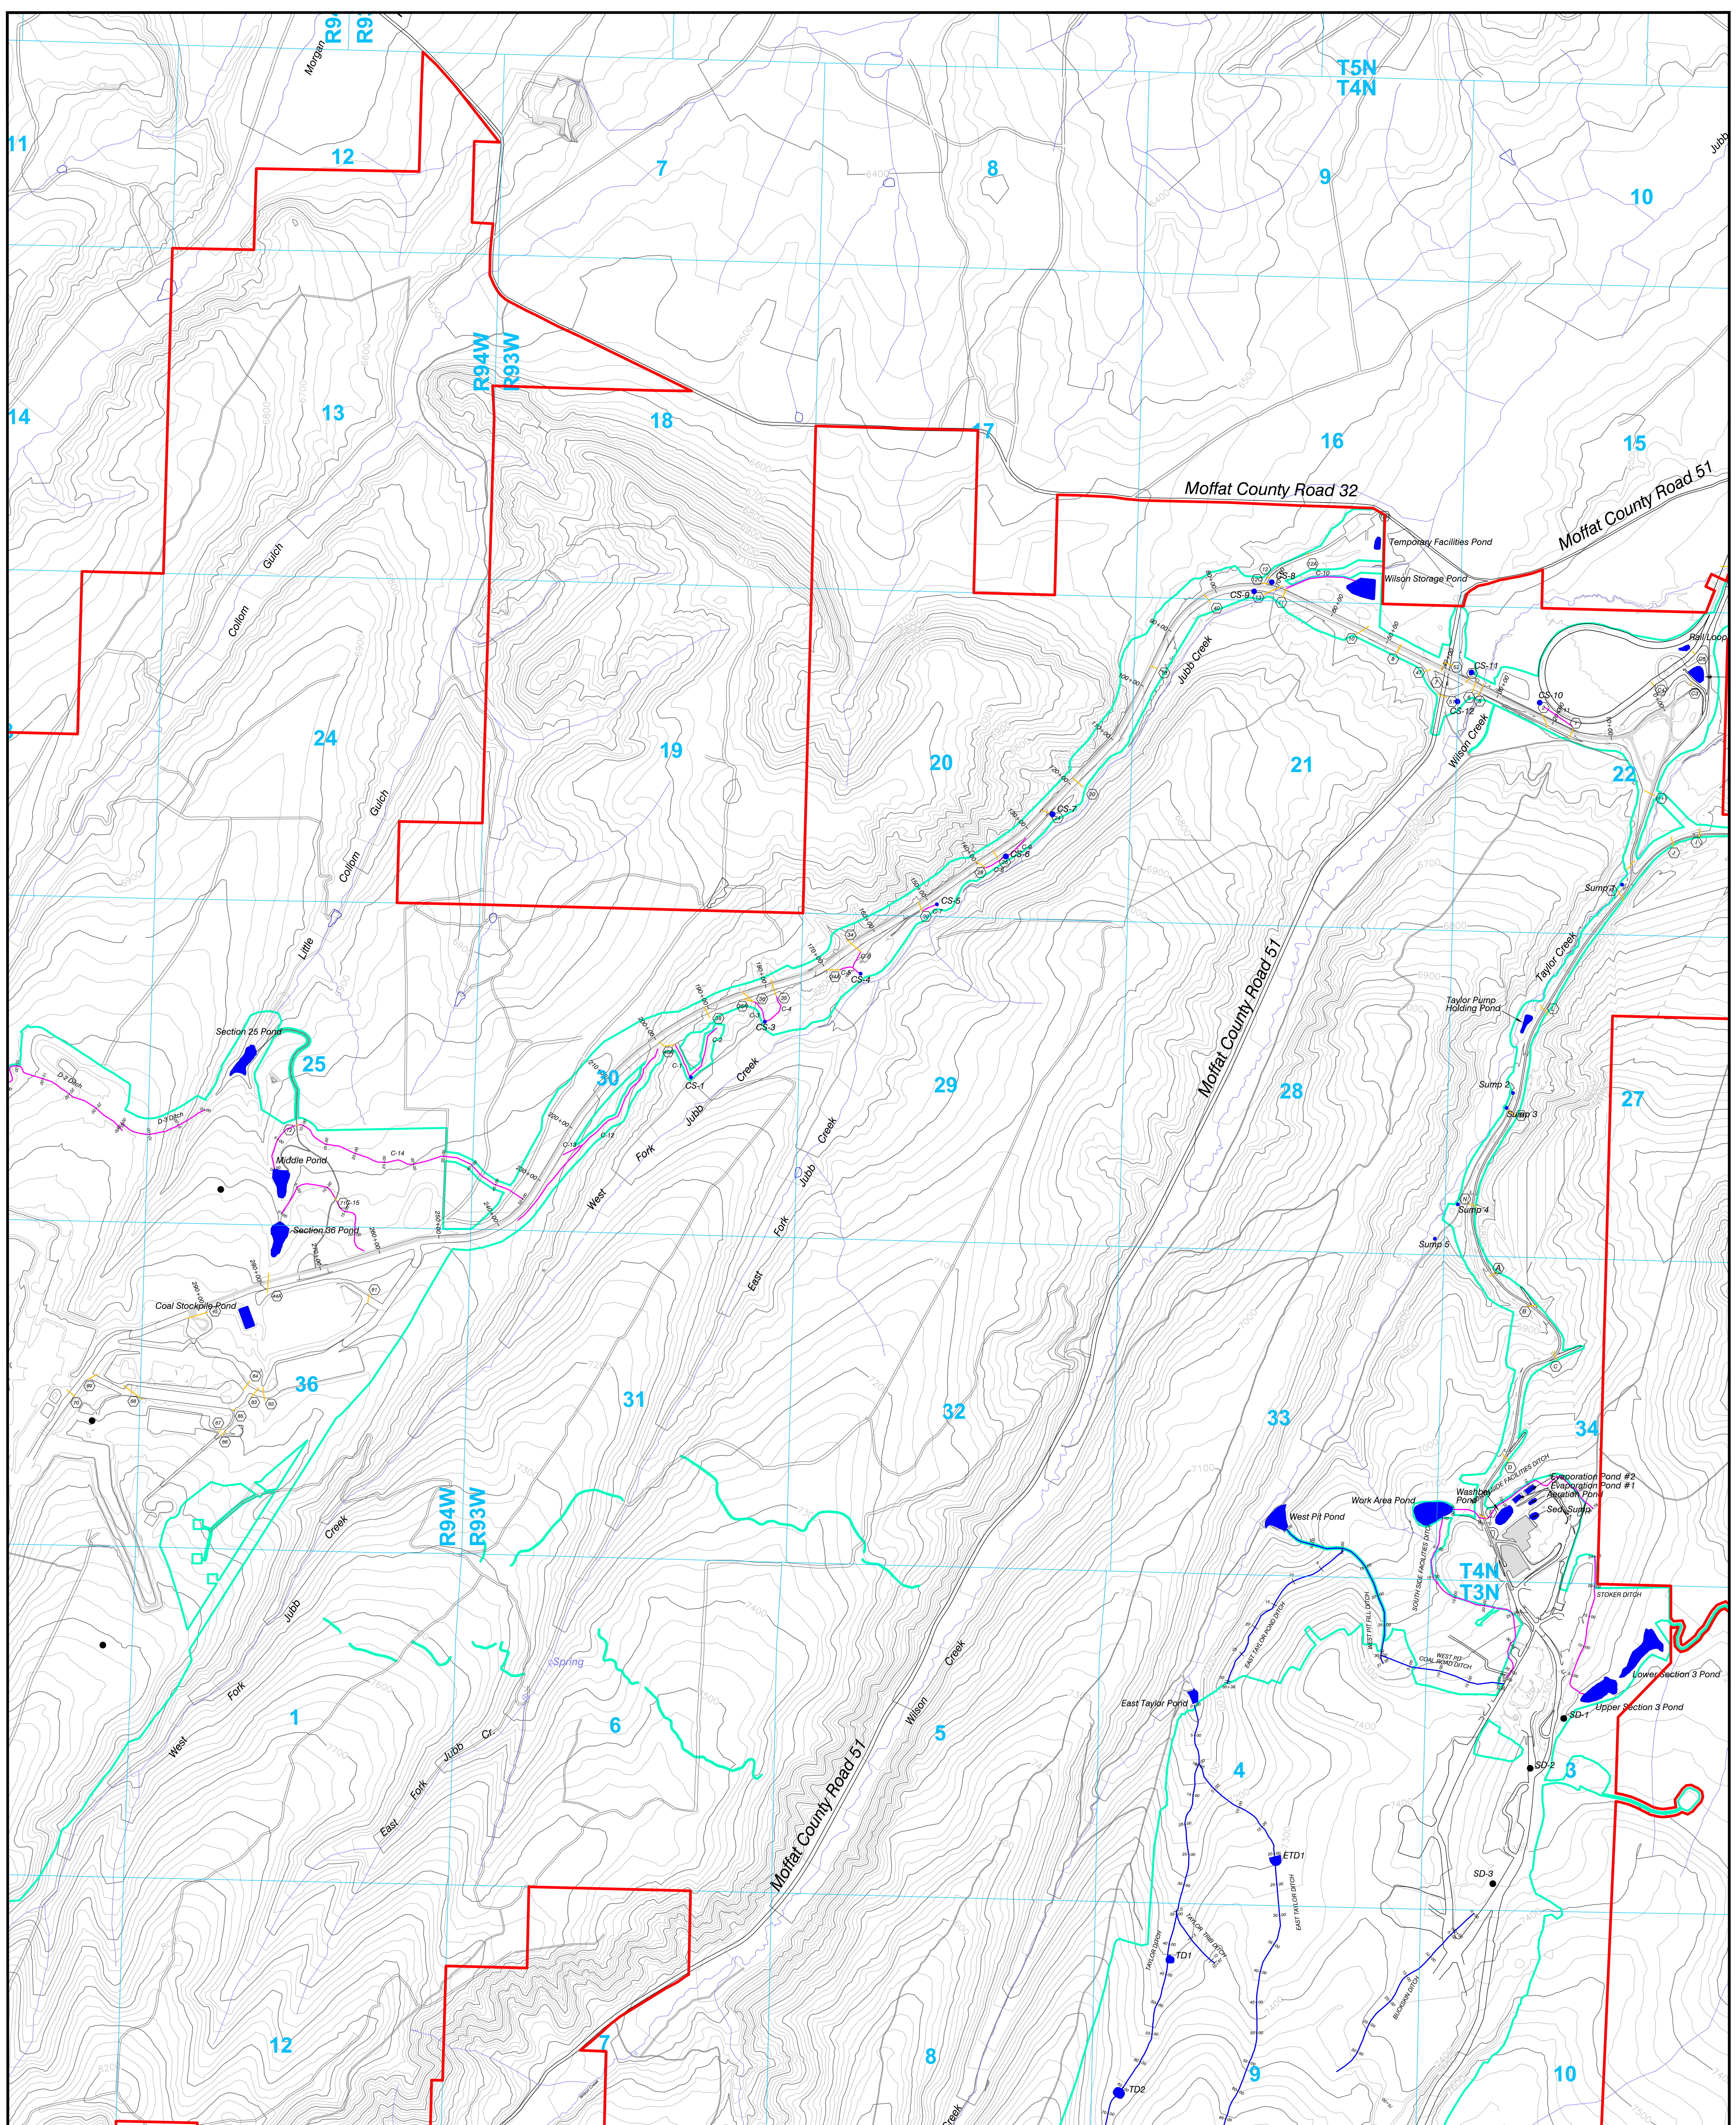

LEGEND

- Permit Boundary
- Disturbance Boundary
- Culvert Locations
- Paved Areas
- Roads
- Permanent Channel Locations
- Temporary Channel Locations
- BMP/Sump Locations (Location Only Not Actual Size)
- Sediment Ponds

0 800' 1600' 2400'

CONTOUR INTERVAL: 25 FT.
June 2020 Topography

CONTOUR INTERVAL: 25 FT.
June 2020 Topography

ENGINEERS CERTIFICATION

I, LEE E. SAMPSON, hereby certify that this map has been reviewed by me and is true and correct to the best of my knowledge and information, relying on information supplied by experts employed by Colowyo Coal Company or qualified consultants working for Colowyo Coal Company, and that I am a Professional Engineer licensed in Colorado as required by the provisions of C.R.S. 12-25-101 through C.R.S. 12-25-119. IN WITNESS WHEREOF, I have hereunder set my hand and affixed my seal.

COLLOM HAUL ROAD

Plan View As-Built

SCALE: 1" = 800'
DATE: 7/20/22
DRAWN BY: Jany
APPROVED BY: DW
DRAWN NO. _____

No.	REVISION	DATE	BY	CHK
TR-149	Removed Culverts, Added Ditches & Sumps	6/18/21	Tony	TR
TR-160	Added Ditches & Sumps	9/18/23	Tony	LES

MAP 25E
Sheet 1 of 4

Notes: Please refer to Map 25I for the as-built configuration of the crossing of Moffat County Road 51 at approximately station 40+00.
Please see Volume 18C Exhibit 7, Item 25F for all culvert sizing information