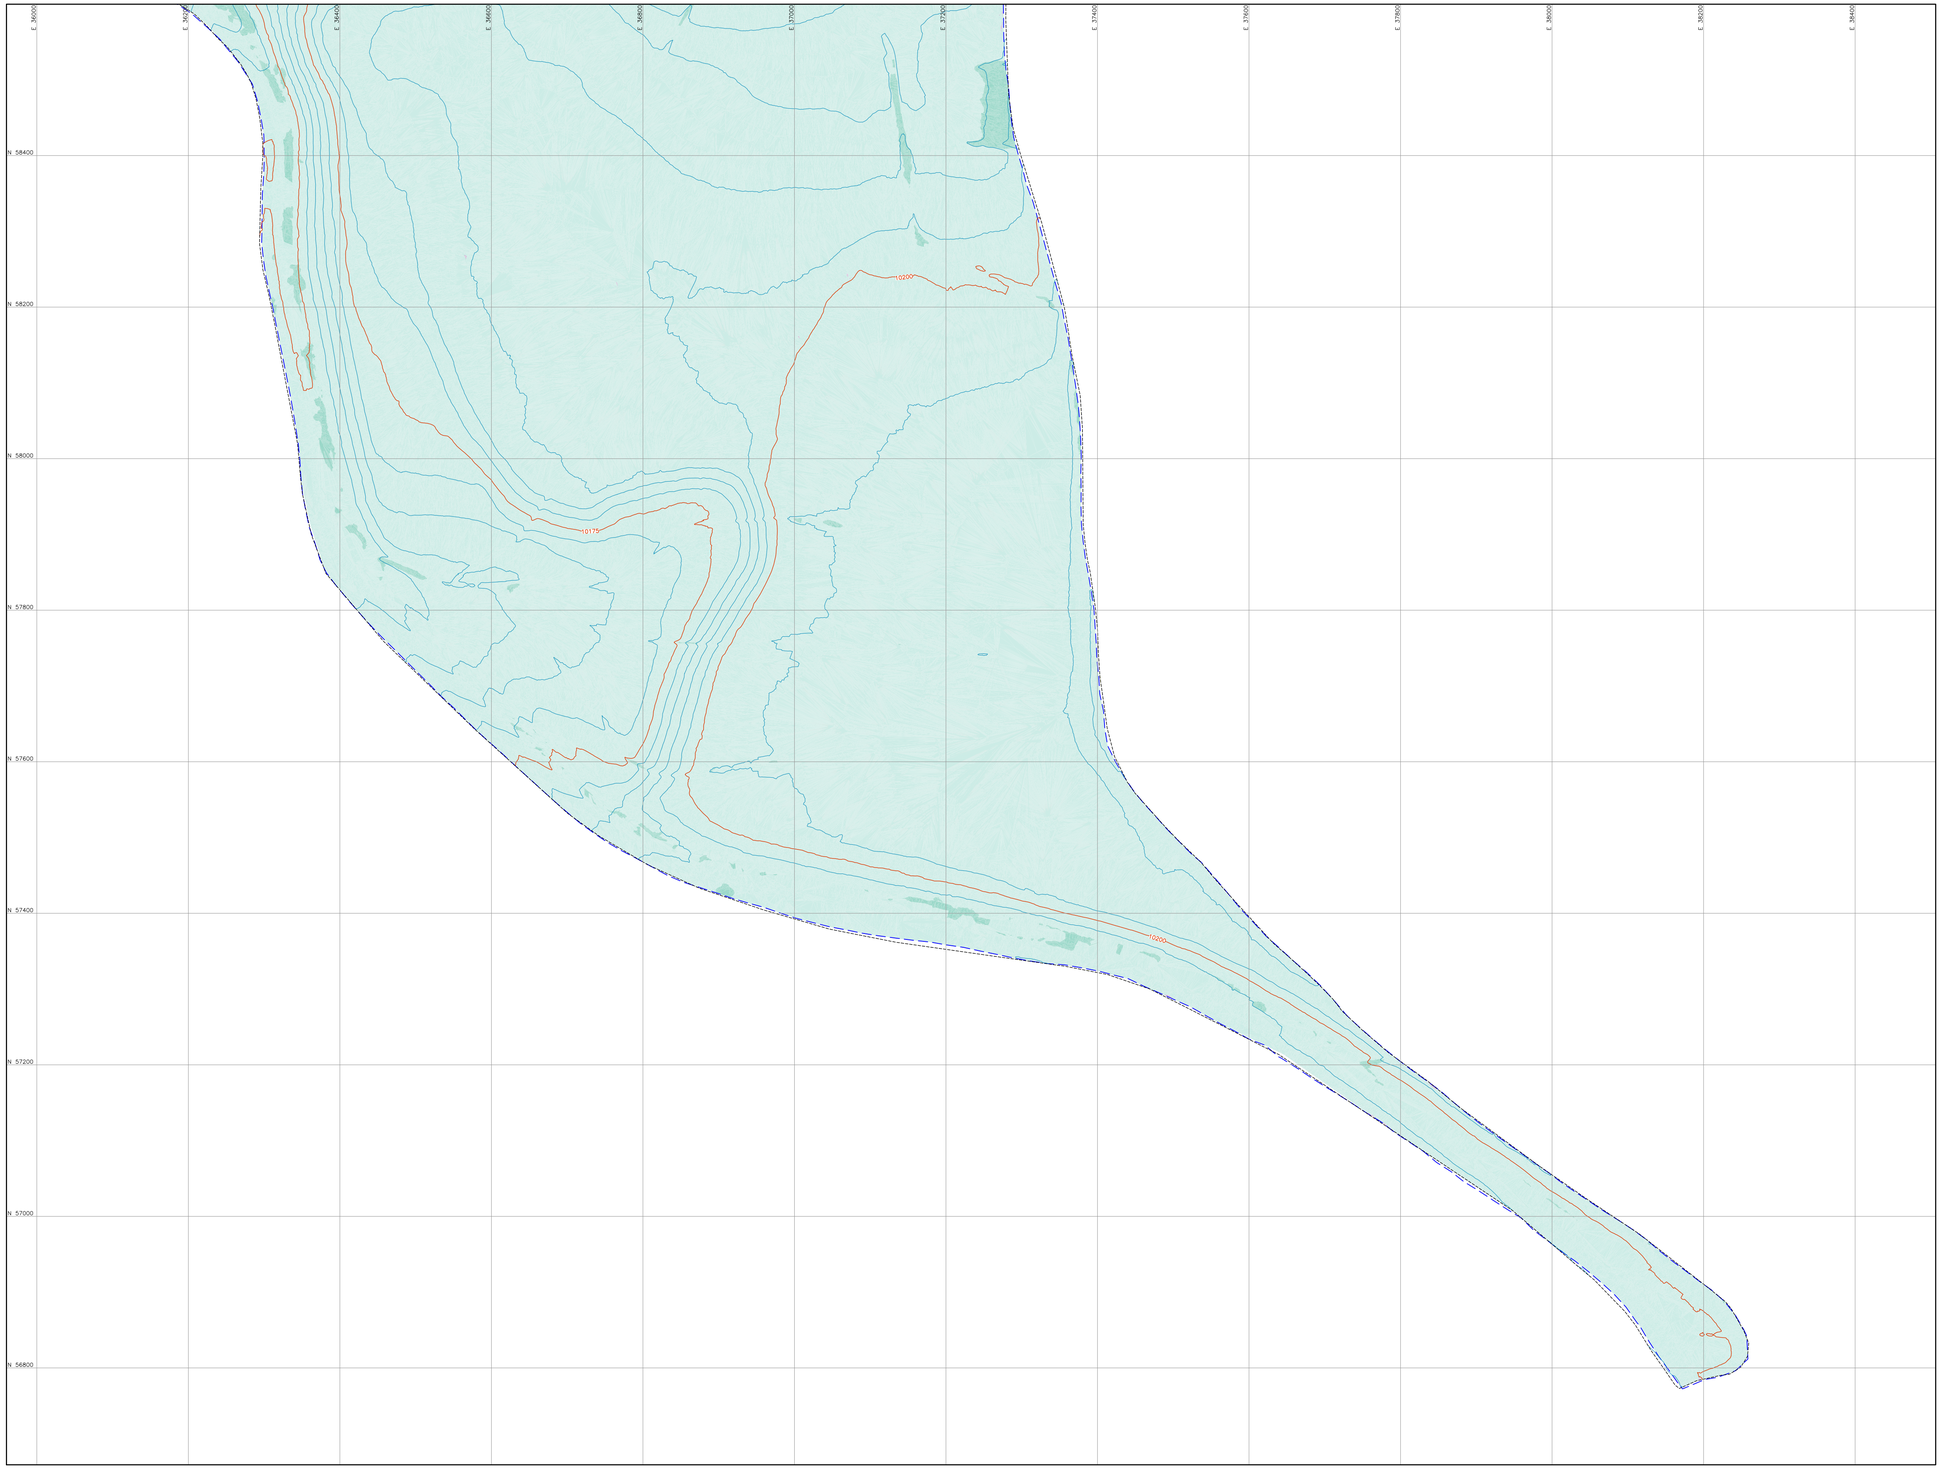

0 50 100 FEET

LEGEND:

- AS-BUILT DCF CONTOURS
- VLF2 PHASE 2 LIMITS
- VLF2 PHASE 3 STAGE A.2 CERTIFICATION LIMITS

Thickness Table			
Number	Minimum Thickness	Maximum Thickness	Color
1	0.000	2.0	
2	2.000	5.0	
3	5.000	11.2	

NOTES:

1. THE ISOPACH THICKNESS IS MEASURED FROM THE TOP OF SLF TO THE TOP OF DCF.
2. THE TOP OF SLF AND TOP OF DCF SURFACES WERE CREATED FROM SURVEY POINTS. ALL SURVEY POINTS WERE NOT TAKEN IN THE SAME LOCATION FOR EACH SURFACE. THIS MAY CAUSE EACH SURFACE TO TRIANGULATE BETWEEN THE POINTS DIFFERENTLY, WHICH PRESENTS FOR ERRORS IN THE ISOPACH DEPTHS.

COLORADO REGISTERED JAMES N. MARTIN 37571 PROFESSIONAL ENGINEER 01-22-2024

REV	DATE	DESCRIPTION	TECH	ENG
##	##	##	##	##
##	##	##	##	##
##	##	##	##	##
##	##	##	##	##
1	05/22/24	RE-ISSUED FOR RECORD OF CONSTRUCTION	RCH	JNM
0	11/01/23	ISSUED FOR RECORD OF CONSTRUCTION	RCH	JNM

APPROVED BY: JNM
CHECKED BY: JNM
DESIGNED BY: JNM
DRAWN BY: RCH

DISCLAIMER

NEWFIELDS PRODUCED THE INFORMATION PRESENTED ON THIS DRAWING THROUGH THE USE OF AVAILABLE TECHNICAL INFORMATION AND EXPERIENCE. RECEIVING THIS DRAWING DOES NOT GUARANTEE ANY RIGHTS TO EITHER SUCH TECHNICAL INFORMATION OR EXPERIENCE. ANY MODIFICATION OR ADAPTATION OF THE DATA OR DRAWING SHALL BE AT USER'S RISK AND WITHOUT ANY LIABILITY OR LEGAL RESPONSIBILITY TO NEWFIELDS.

NewFields

CLIENT: CRIPPLE CREEK & VICTOR GOLD MINING COMPANY

PROJECT: VLF 2 PHASE 3 STAGE A.2

TITLE: DCF ISOPACH (SHEET 2 OF 2)

FILENAME: 0106.060.002M

DRAWING NO.: 12

REVISION: 1

E:\Projects\0106.060 VLF2 2023 01 On-Site Support\A-CAD\DWG\0106.060.002M.dwg 1/23/2024 4:55 PM