


## LEGEND

- PERMIT BOUNDARY
- HISTORICAL REVEGETATED AREA
- SC-D-92 — SHRUB CLUMP/Pit ID/Year Constructed
- 2023 TOPSOIL STRIP
- 2023 RETOPSOILED, NOT REVEGETATED
- 2023 RETOPSOILED AND REVEGETATED AREA
- 2023 TOPSOIL STRIPPED, RETOPSOILED AND REVEG
- 2023 TOPSOIL STRIPPED, RETOPSOILED NO REVEG
- EXISTING TOPSOIL STOCKPILE
- ASH DUMP STORAGE AREA
- 2024 PROPOSED TOPSOIL LAYDOWN
- 2024 PROPOSED TOPSOIL STRIP
- 2024 PROPOSED TOPSOIL STRIPPING AND LAYDOWN
- ACCESS CORRIDORS
- EXISTING STOCK POND
- EXISTING DOZER BASINS
- RECONSTRUCTED DRAINAGES
- 2023 RECONSTRUCTED DRAINAGES
- CONTOUR DITCH
- APPROVED PHASE III BOND RELEASED BOUNDARY
- AS-BUILT HIGHWALL MINING AREA
- PROPOSED TOPSOIL STOCKPILE

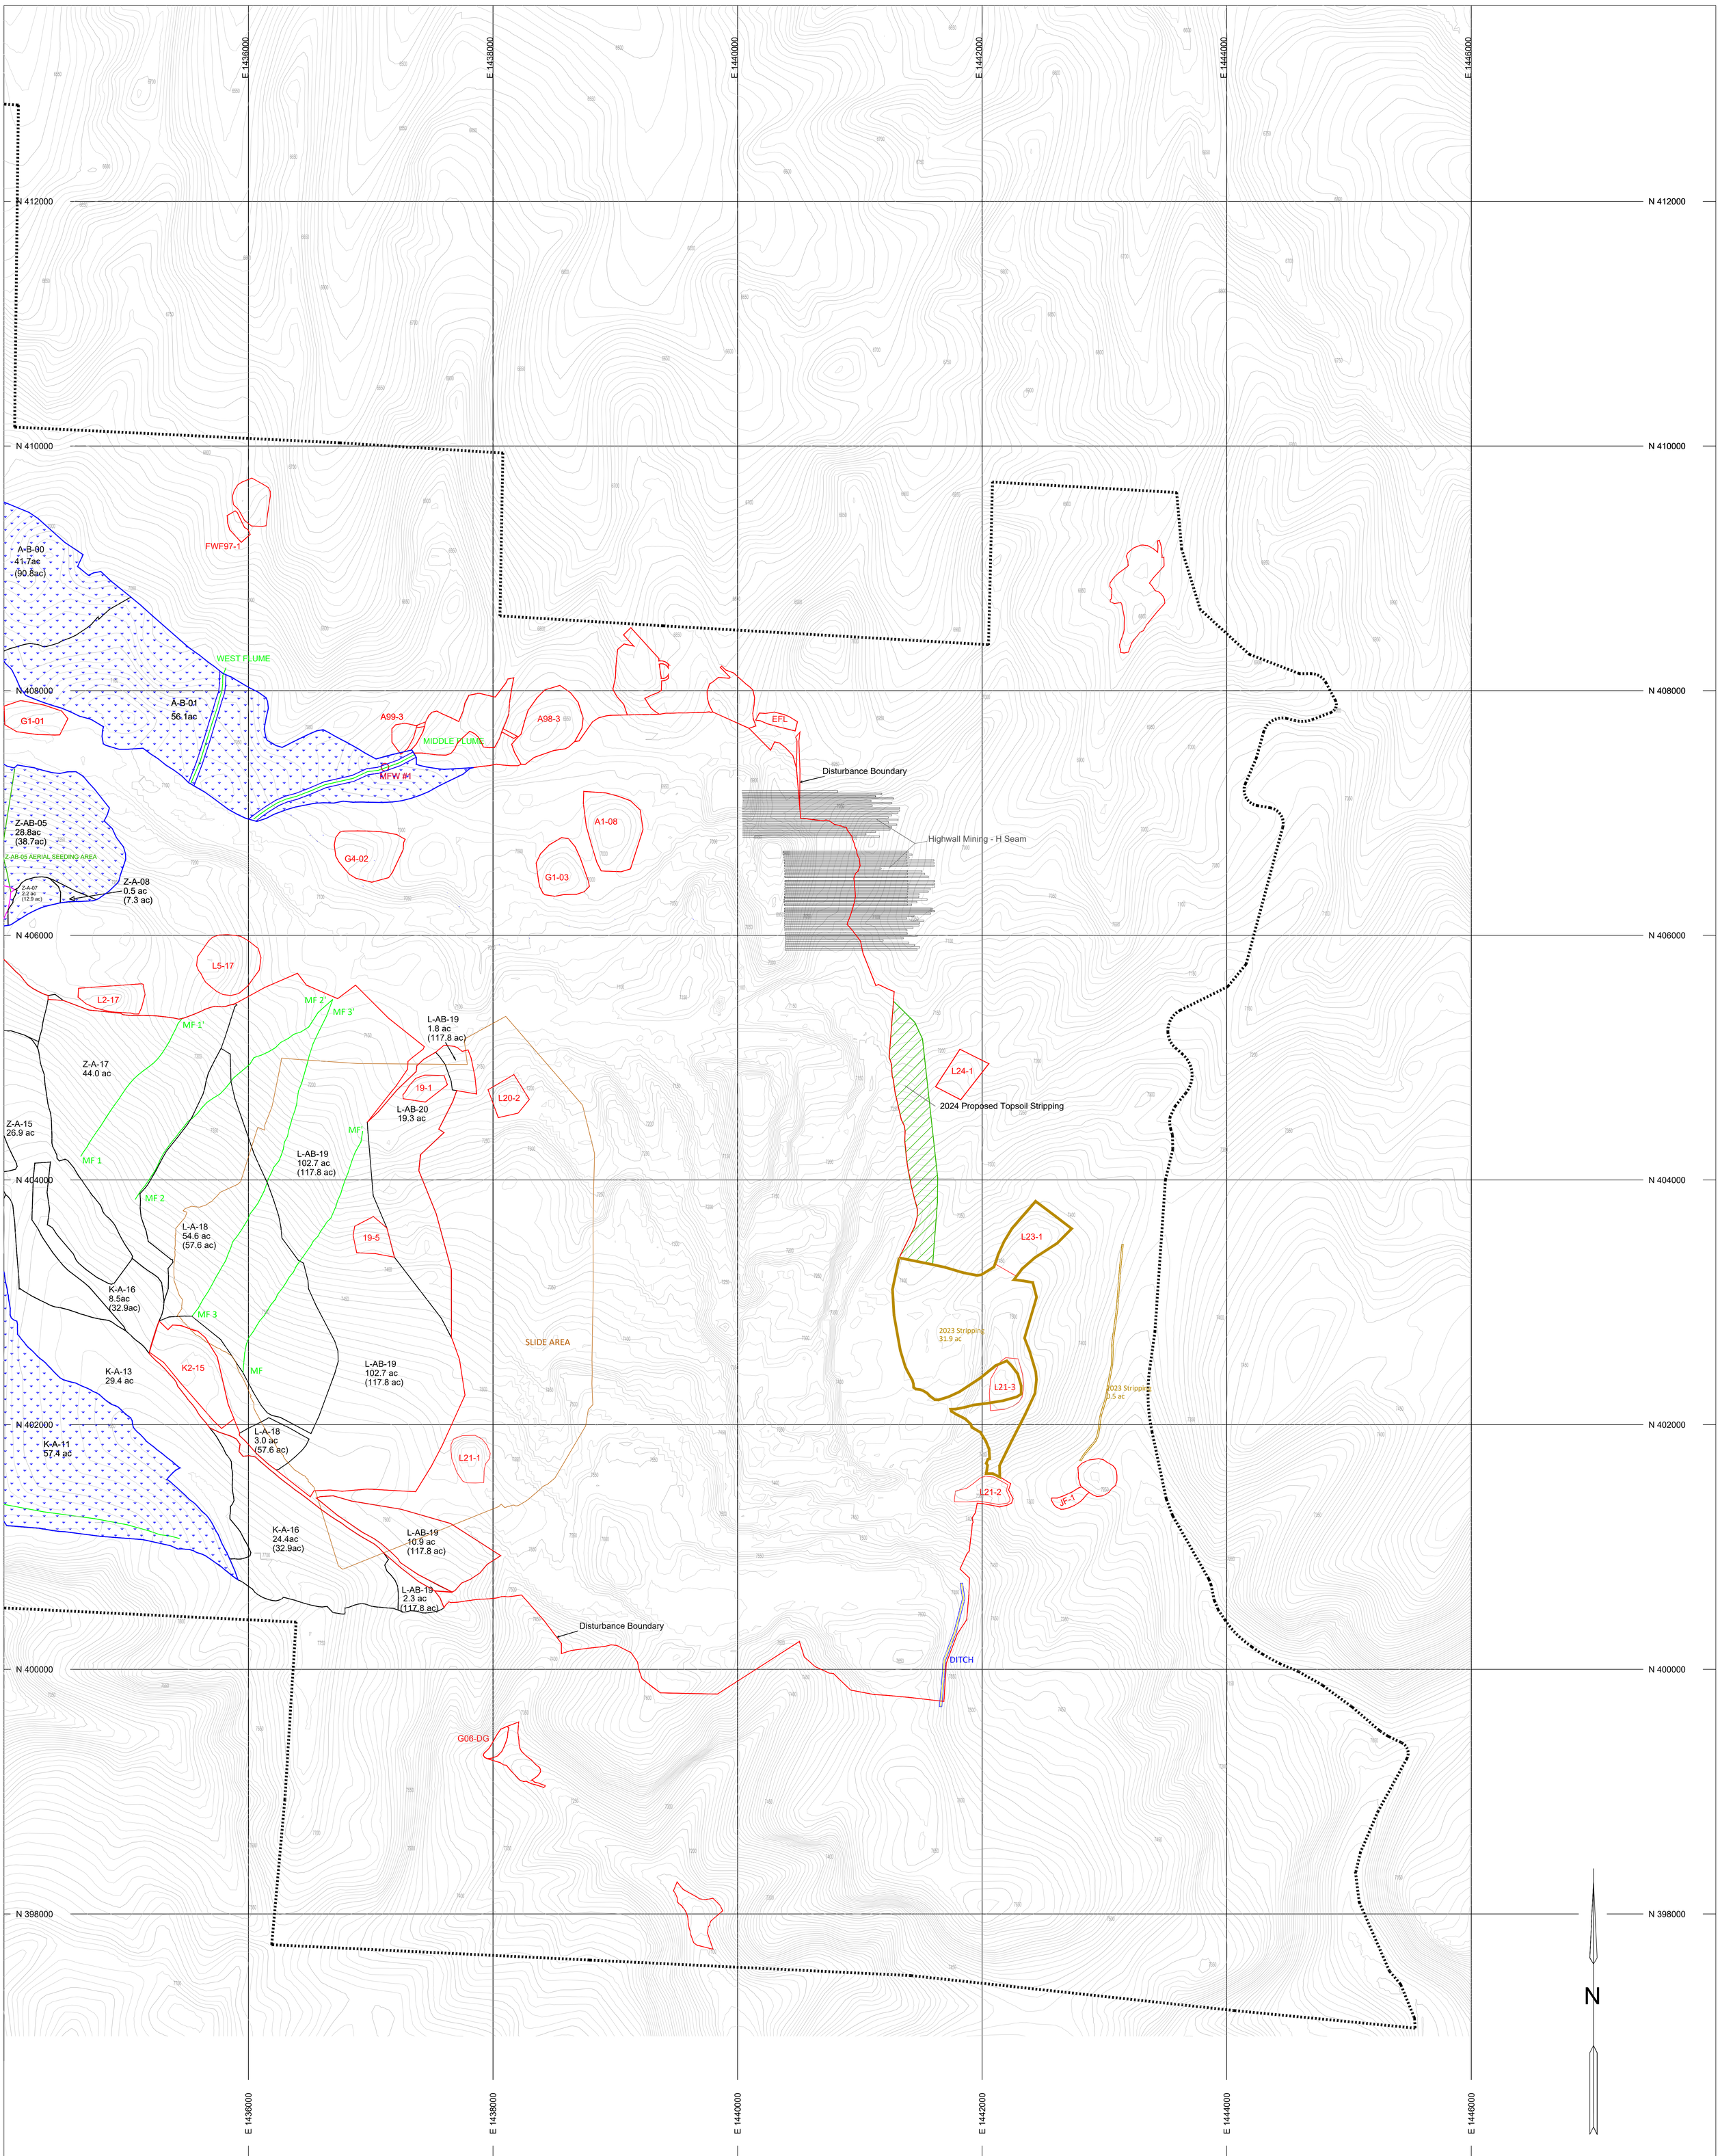


SHEET LOCATION INDEX

400 0 400 800 1200

SCALE: 1 IN = 400 FT

CONTOUR INTERVAL: 10 FEET

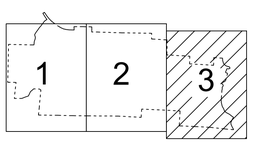Topographic information compiled from aerial photography dated 11/2023.

AutoCAD file: L:/Engineer/Permits/Annual Reports/2023/Maps/rec_map_2023.dwg

TRAPPER MINING INC.

TRAPPER MINE — CRAIG, CO.

# PERMIT C81-010

# 2023 ANNUAL RECLAMATION REPORT MAP

SCALE: 1 in = 400 ft
DESIGNED BY: GCR
DRAWN BY: JMM
DATE: 3/11/24

Sheet 3 of 3

MAP 1

SHEET 3

Trapper Mine