


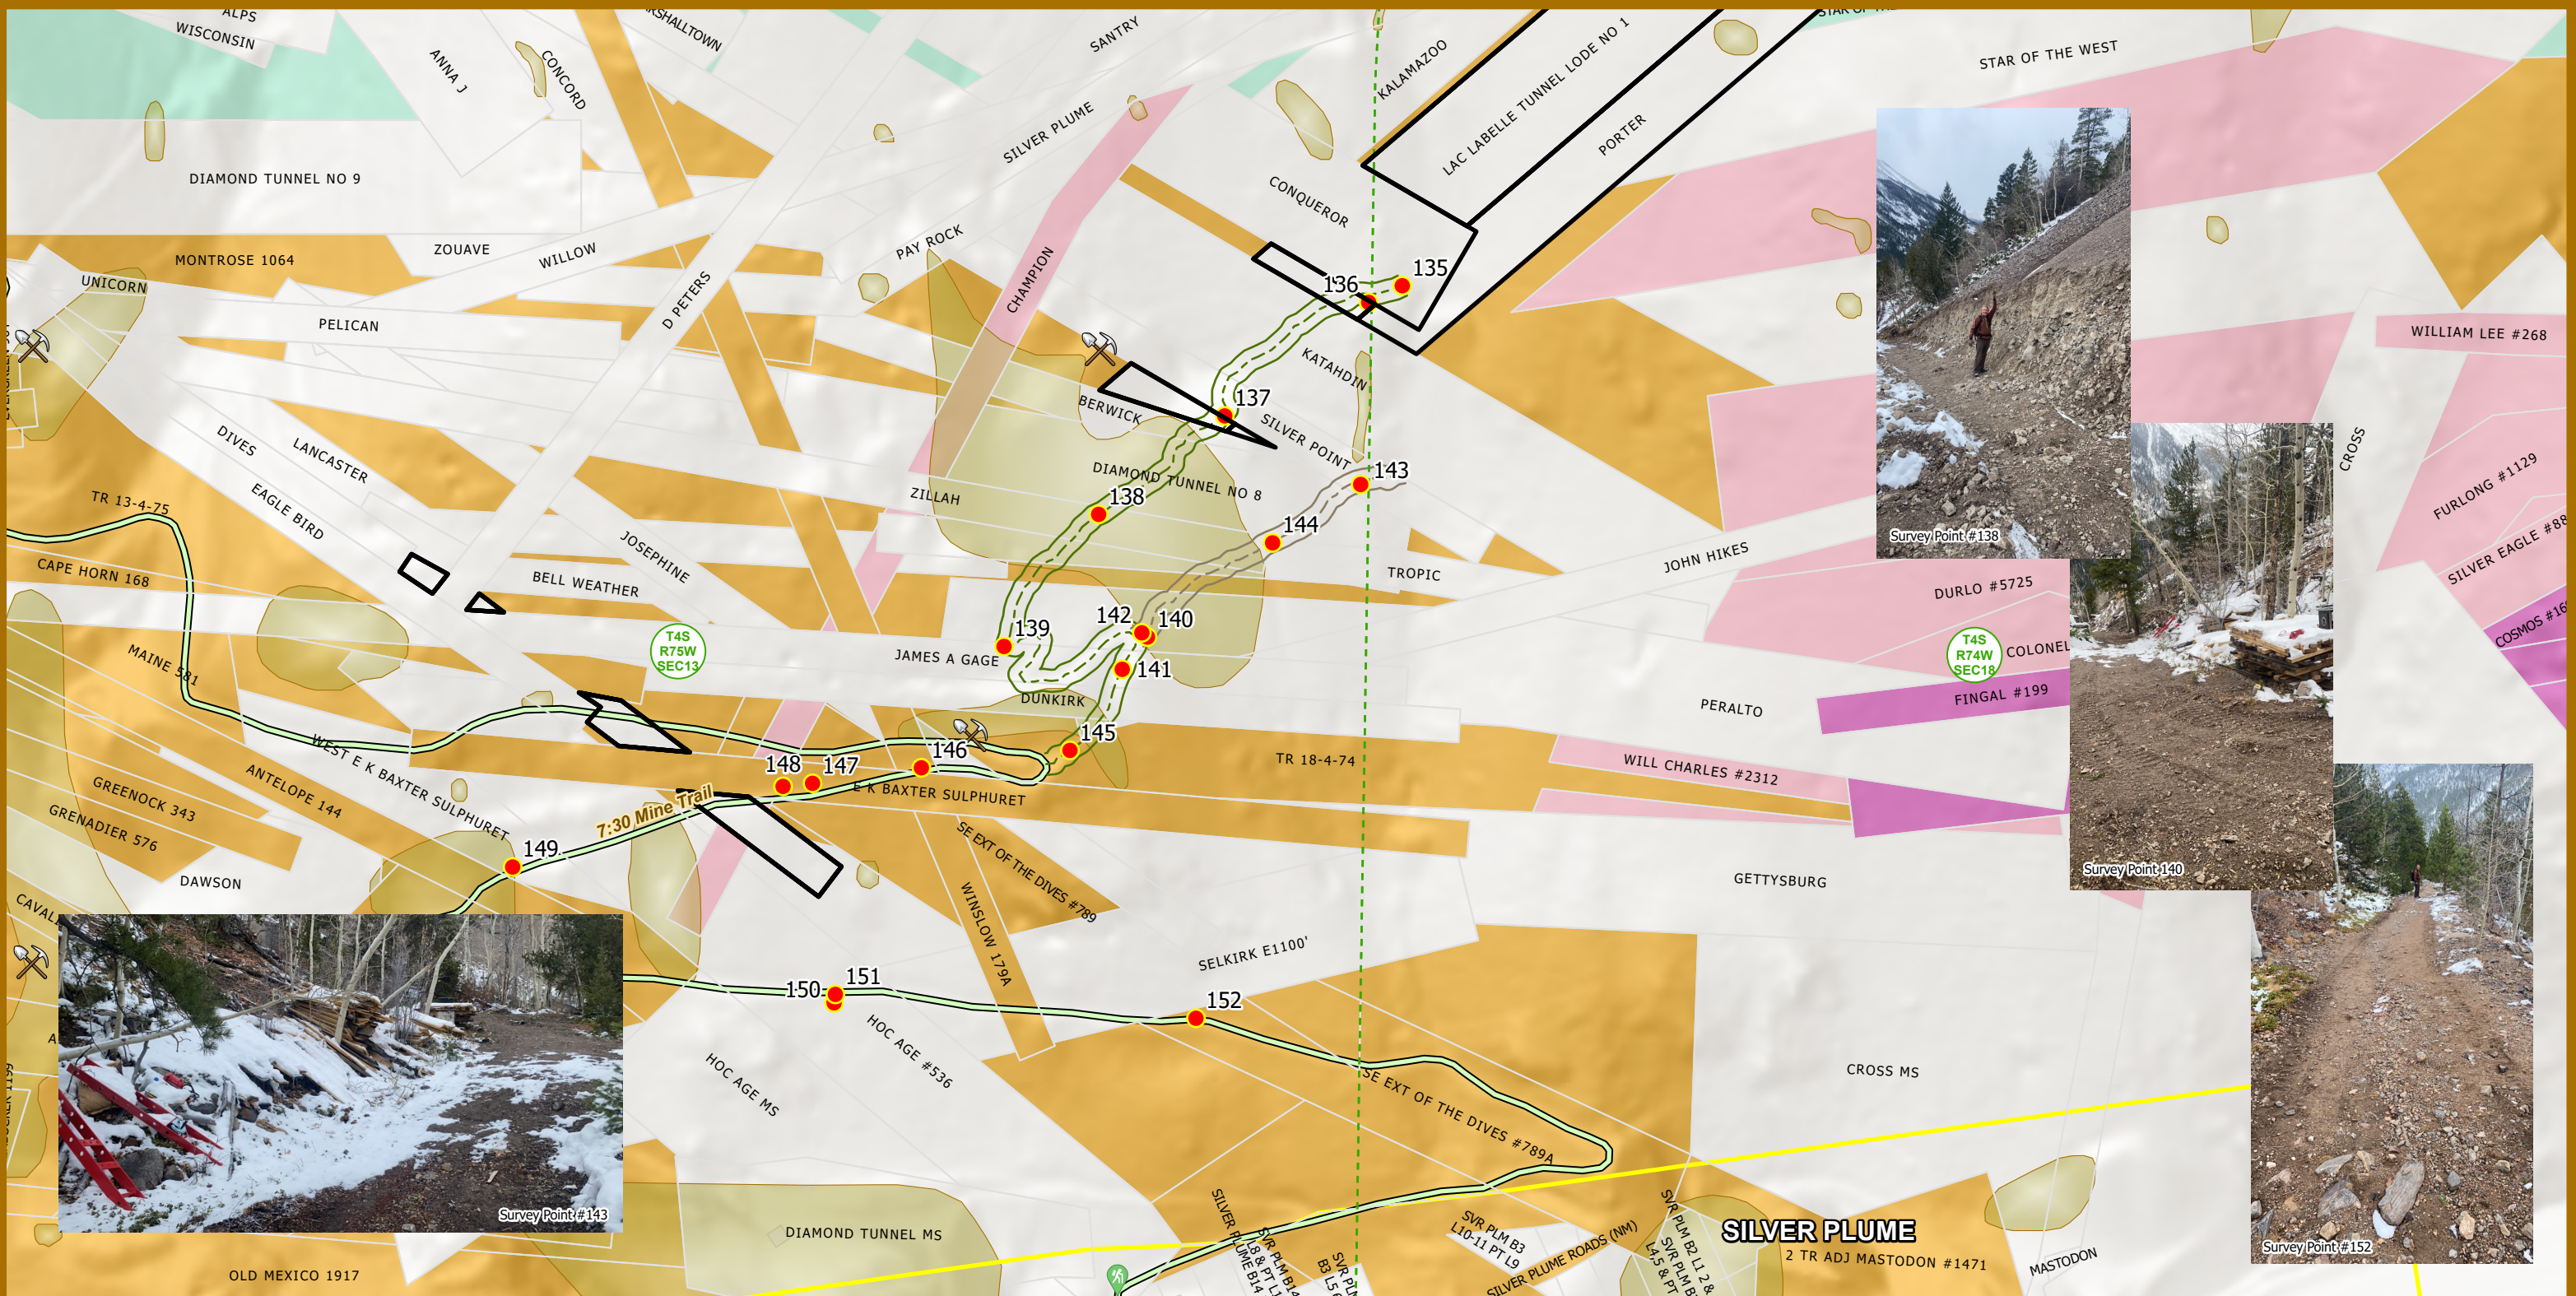

This map depicts approximately 5600ft of an illegally built road off the 7:30 Mine Trail. Upper sections were built with a mini-excavator while the lower stretch was built by hand. Data collected Nov 5, 2024 by the Trails Team.

This map is a visual representation only, do not use for legal purposes. Map is not survey accurate and may not comply with National Mapping Accuracy Standards. Map is based on best available data as of Nov 2024.



- Mine Sites
- Mine Waste
- 7:30 Mine Trail
- Public Land Survey System
- Silver Plume Boundaries
- Survey Data Locations

- Illegal Road Segments**
- Hand dug route surveyed with +/- 5.02m horizontal accuracy
 - Machine built road surveyed with a +/- 4.86m horizontal accuracy

- Parcel Ownership**
- Clear Creek County
 - Private
 - Silver Plume
 - State Historical Society
 - U.S.F.S.
 - Eli R Josephs Parcels



Path: H:\ArcGISPro_Projects\Open Space\Plume\IllegalRd.aprx

ILLEGAL ROAD BUILT OFF 7:30 MINE TRAIL