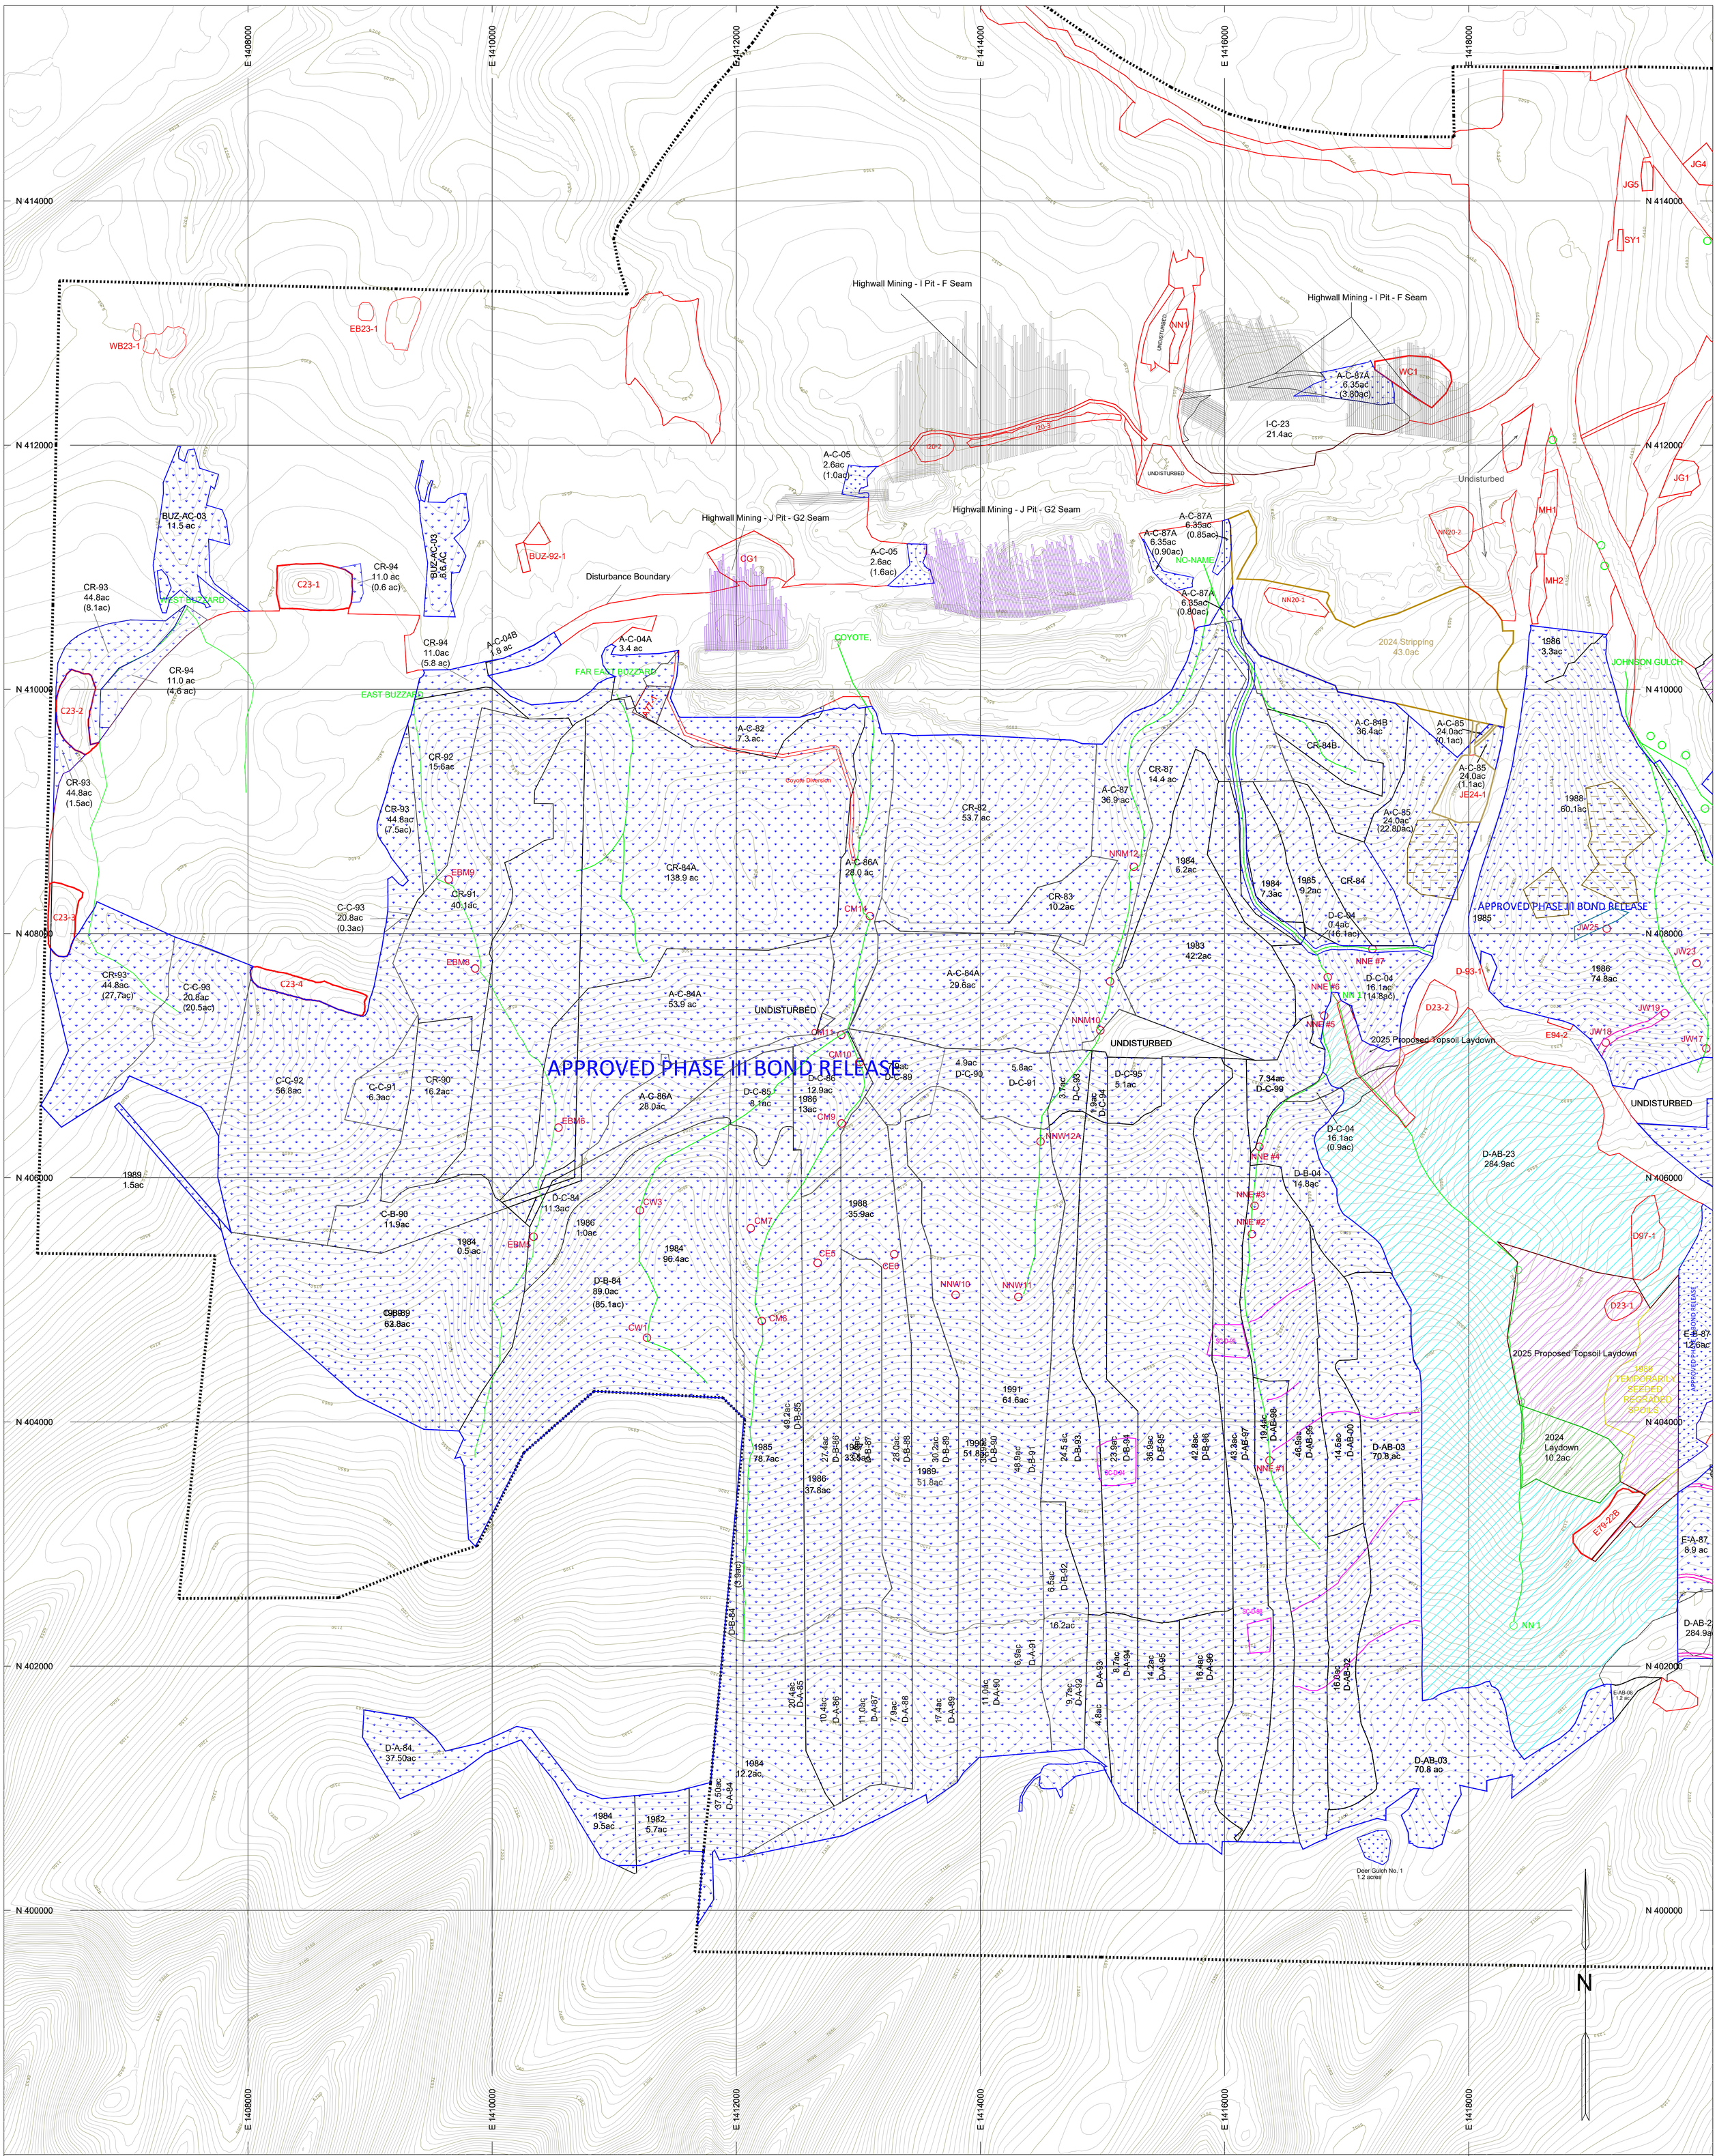

LEGEND

- PERMIT BOUNDARY
- HISTORICAL REVEGETATED AREA
- SC-D-92 SHRUB CLUMP/Pit ID/Year Constructed
- 2024 TOPSOIL STRIP
- 2024 RETOPSOILED, NOT REVEGETATED
- 2025 PROPOSED TOPSOIL LAYDOWN
- 2025 PROPOSED TOPSOIL STRIP
- EXISTING TOPSOIL STOCKPILE
- ASH DUMP STORAGE AREA
- AS-BUILT HIGHWALL MINING AREA
- PROPOSED TOPSOIL STOCKPILE
- 2023 TOPSOIL LAYDOWN NOT REVEGETATED
- ACCESS CORRIDORS
- EXISTING STOCK POND
- EXISTING DOZER BASINS
- RECONSTRUCTED DRAINAGES
- CONTOUR DITCH
- APPROVED PHASE III BOND RELEASED BOUNDARY

1 2 3

SHEET LOCATION INDEX

400 0 400 800 1200

SCALE: 1 IN = 400 FT

CONTOUR INTERVAL: 10 FEET

Topographic information compiled from aerial photography dated 12/2024.

AutoCAD file: L:/Engineer/Permits/Annual Reports/2024/Maps/rec_map_2024.dwg

TRAPPER MINING INC.

TRAPPER MINE CRAIG, CO.

PERMIT C81-010

2024 ANNUAL RECLAMATION REPORT MAP

SCALE: 1in = 400 ft
DESIGNED BY: GCR
DRAWN BY: JMM
DATE: 3/15/25

Sheet 1 of 3

MAP 1

SHEET 1